


MEDIUM PRESSURE, CONSTANT VOLUME 100% O.A. SYSTEM  
I-AC-2 & 1-HRU-1&2

- OPERATING SEQUENCE**
1. SYSTEM OPERATION IS STARTED FROM THE ECC AND RUNS CONTINUOUSLY. SYSTEM CAN BE STOPPED FROM THE ECC. WHEN STOPPED, STOPPED, SF AND FAN 1-VAF146 START, AND POD2 OPENS. WHEN STOPPED, SF AND FAN 1-VAF146 STOP, POD2 CLOSES. COMMANDS FROM ECC ARE ALL VIA DDC PANEL.
  2. HRO1 IS STARTED FROM THE ECC AND RUNS CONTINUOUSLY. WHEN STOPPED, POD3 OPENS. WHEN STOPPED, POD3 CLOSES.
  3. DURING OPERATION, T-2 MODULATES V-4 AND V-5 IN SEQUENCE TO MAINTAIN 51°F. (HTS)
  4. DURING OPERATION, T-2 MODULATES V-3 TO MAINTAIN 57°F. (SEE SUPPLY AIR TEMPERATURE RESET BELOW.) (COOLING)
  5. T-1 CLOSING V-4 TO COIL (AT 50°F.).
  6. V-5 SHALL BE CLOSED TO FLOW THROUGH COIL BETWEEN 57°F. AND 78°F. O.A. PUMP 1-PS1 IS OFF. ABOVE 78°F., V-5 SHALL OPEN TO FLOW THROUGH COIL.
  7. ELECTRIC FREEZE/STAT F1 STOPS SF WHENEVER TEMPERATURE IS BELOW 36°F.
- STARTING AND STOPPING**
1. WHEN SYSTEM OPERATION IS STARTED FROM ECC, PRESSURE SWITCH P01 STOPS SUPPLY FAN SHOULD O.A. PLenum PRESSURE FALL BELOW MINUS 2" W.G. PRESSURE SWITCH P02 STOPS SF SHOULD PRESSURE RISE ABOVE 4" W.G. PRESSURE SWITCH P03 STOPS FAN SHOULD PRESSURE RISE ABOVE 3" W.G. PRESSURE SWITCH SHALL BE MANUAL RESETTABLE TYPE.
- HUMIDITY CONTROL**
1. O.A. THERMOSTAT T1 SHALL CLOSE ON-OFF TWO-WAY CONTROL VALVE V-1 WHEN OUTSIDE AIR RISES ABOVE 70°F., AND OPEN VALVE V1 WHEN OUTSIDE AIR DROPS BELOW 70°F.
  2. DUCT HUMIDITY SENSOR H1 SHALL MODULATE VALVE V2 TO MAINTAIN THE DESIRED RELATIVE HUMIDITY (30% RH) SUBJECT TO ITS MODULATING TYPE HIGH LIMIT DUCT HUMIDITY SENSOR H2 SET AT 80% RELATIVE HUMIDITY. VALVE V2 SHALL CLOSE UNTIL CONDENSATE APPROACHES STEAM TEMPERATURE.
- SMOKE CONTROL**
1. WHEN SMOKE IS SENSED AT S01, SF STOPS, P001 AND S001 CLOSE. 1-HRU2 RUNS.
  2. WHEN SMOKE IS SENSED AT S02, 1-HRU2 STOPS, P002 CLOSES.
  3. WHEN SMOKE IS SENSED AT S03, 1-HRU1 STOPS, P003 CLOSES.
- SUPPLY AIR TEMPERATURE RESET**
1. KEY REQUEST ON EXHAUST AIR HUMIDISTAT H-3, SET AT 60% RH WITH GREATEST COOLING DEMAND RESETS T-2 TO MINIMUM TEMPERATURE.
  2. KEY ZONES ARE INDICATED ON DRAWINGS.

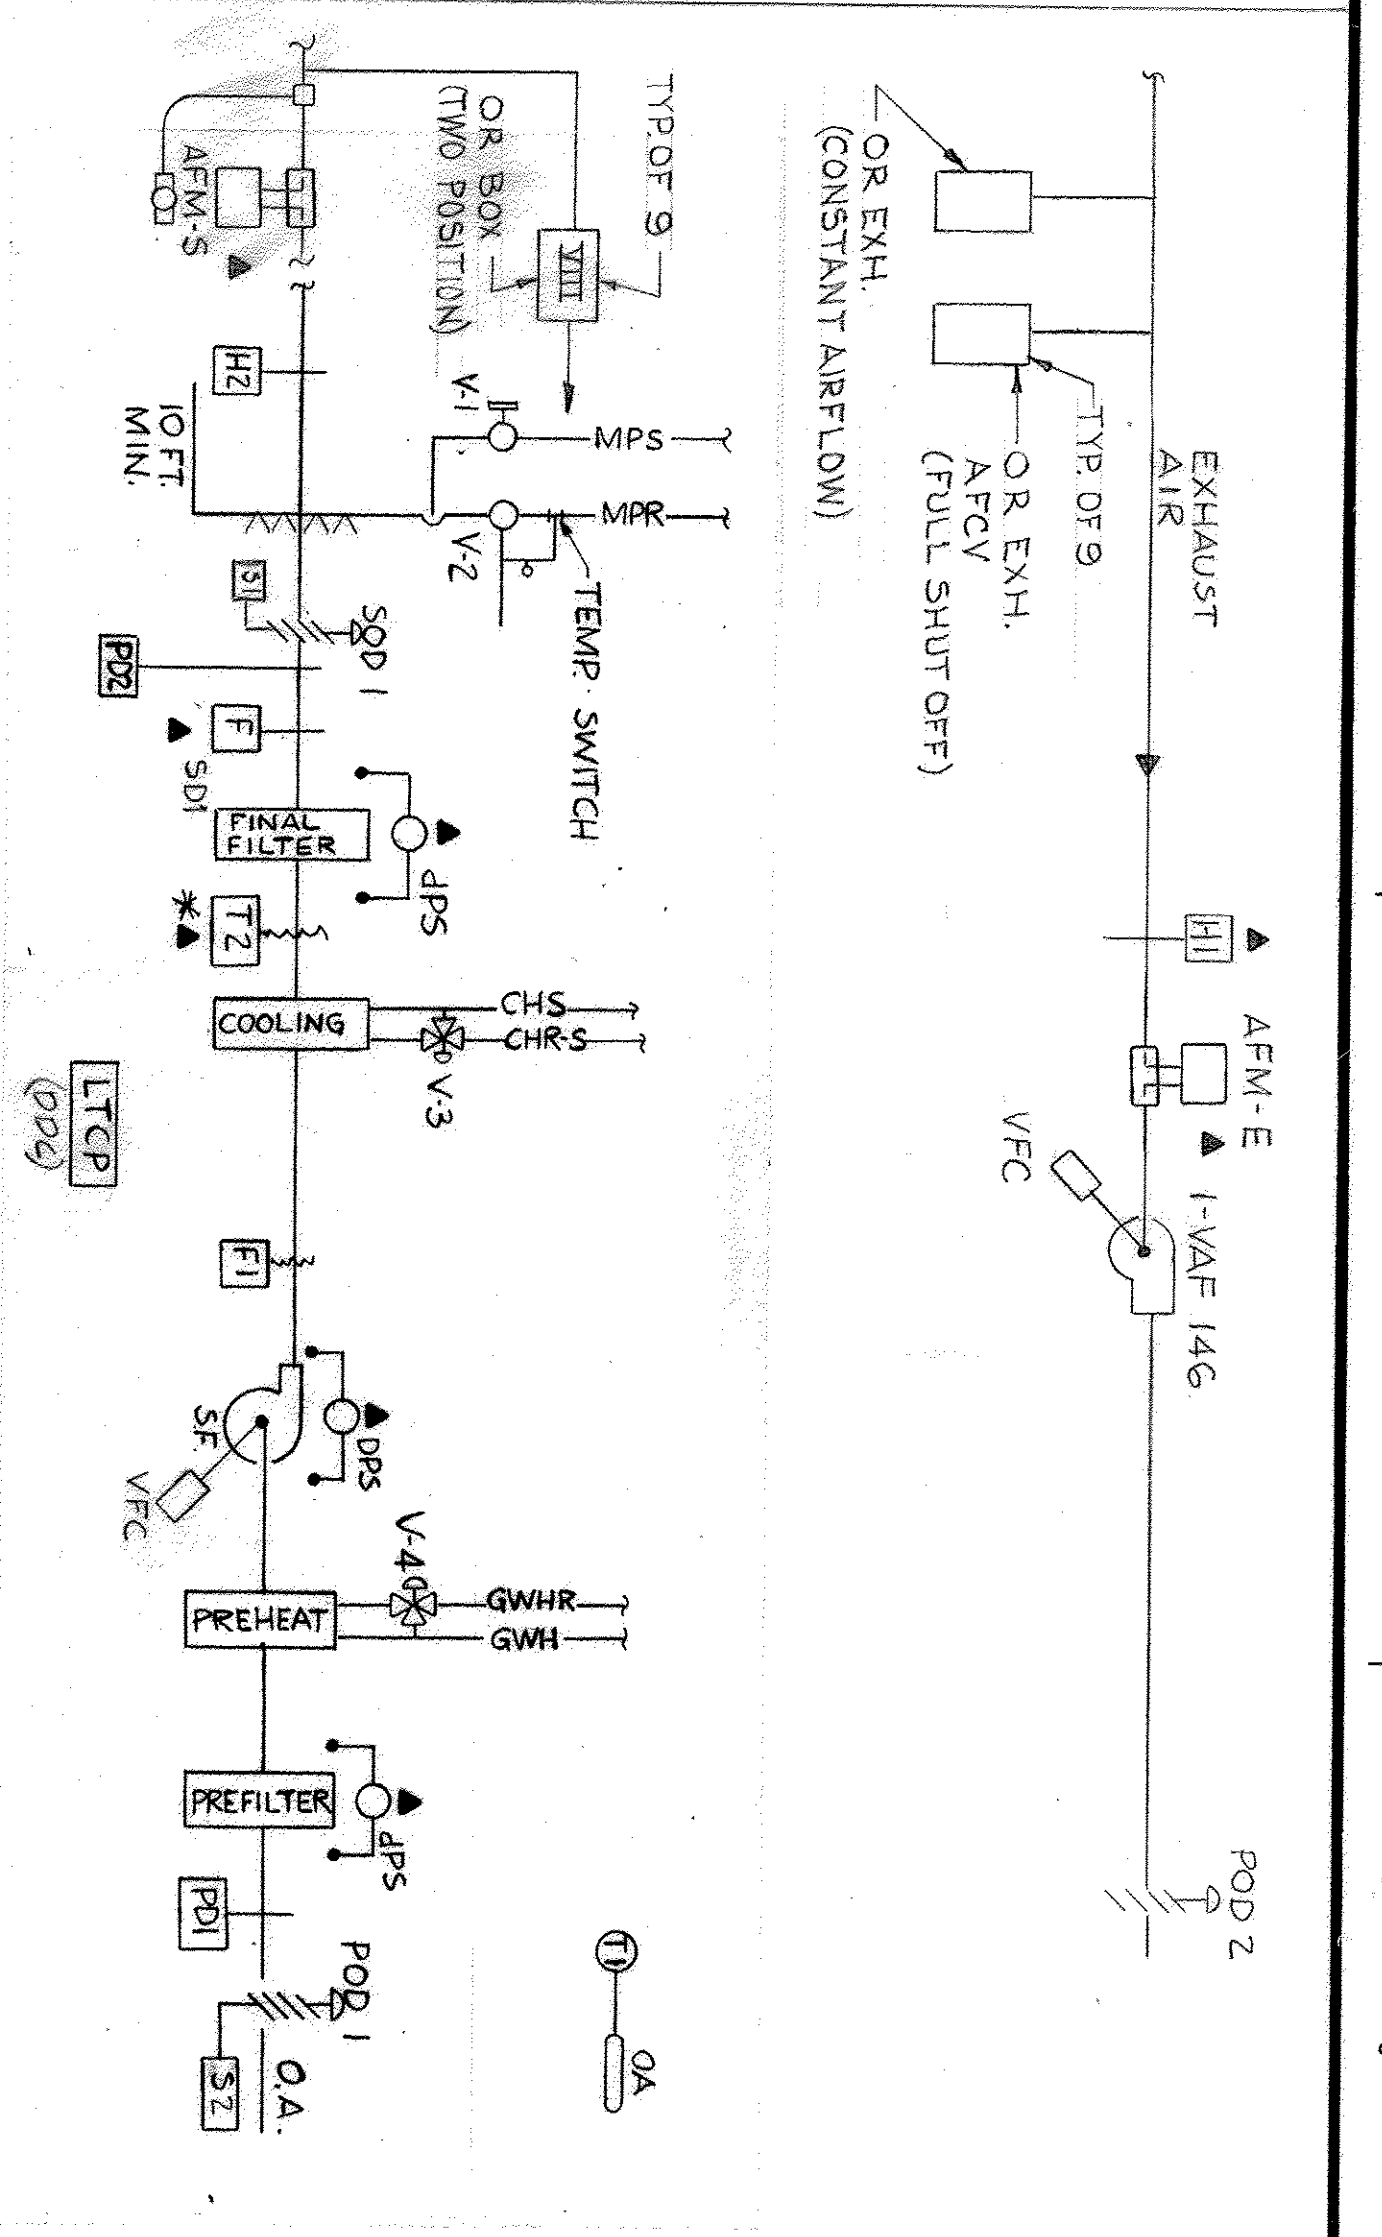

SURGICAL MEDIUM PRESSURE, CONSTANT VOLUME 100% O.A. SYSTEM  
1-AC-32 1-VAF 146

- OPERATING SEQUENCE**
1. SYSTEM IS STARTED AND STOPPED FROM THE ECC. WHEN STOPPED, P001 AND S001 CLOSE. WHEN END SWITCHES S1 AND S2 ARE ENGAGED, SF AND FAN 1-VAF146 START, AND P002 OPENS. WHEN STOPPED, SF AND FAN 1-VAF146 STOP, P002 CLOSES. AFTER 2-MINUTE DELAY (ADJUSTABLE 0-5 MINUTES) P001 AND S001 CLOSE. COMMANDS FROM ECC ARE VIA DDC PANEL.
  2. DURING OPERATION, T-2 MODULATES V-4 IN SEQUENCE TO MAINTAIN 51°F.
  3. DURING OPERATION, T-2 MODULATES V-3 TO MAINTAIN 51°F.
  4. DURING OPERATION WHEN O-A AT T-1 IS ABOVE 59°F., T-1 CLOSING V-4 TO COIL.
  5. ELECTRIC FREEZE/STAT F1 STOPS SF WHENEVER TEMPERATURE IS BELOW 36°F.
- STARTING AND STOPPING**
1. WHEN SYSTEM OPERATION IS STARTED FROM ECC, PRESSURE SWITCH P01 STOPS SUPPLY FAN SHOULD O.A. PLenum PRESSURE FALL BELOW MINUS 2" W.G. PRESSURE SWITCH P02 STOPS SF SHOULD PRESSURE RISE ABOVE 4" W.G. PRESSURE SWITCH SHALL BE MANUAL RESETTABLE TYPE.
- HUMIDITY CONTROL**
1. O.A. THERMOSTAT T1 SHALL CLOSE ON-OFF TWO-WAY CONTROL VALVE V-1 WHEN OUTSIDE AIR RISES ABOVE 70°F., AND OPEN VALVE V1 WHEN OUTSIDE AIR DROPS BELOW 70°F.
  2. DUCT HUMIDITY SENSOR H1 SHALL MODULATE VALVE V2 TO MAINTAIN THE DESIRED RELATIVE HUMIDITY (30% RH) SUBJECT TO ITS MODULATING TYPE HIGH LIMIT DUCT HUMIDITY SENSOR H2 SET AT 80% RELATIVE HUMIDITY. VALVE V2 SHALL CLOSE UNTIL CONDENSATE APPROACHES STEAM TEMPERATURE.
- SMOKE CONTROL**
1. WHEN SMOKE IS SENSED AT S01, SF STOPS, P001 AND S001 CLOSE. FAN VAF146 RUNS.
- FAN CAPACITY CONTROL - SEE DRAWING 1-H03**
- OCCUPIED-UNOCCUPIED MODES**
1. SYSTEM MODE IS CONTROLLED BY ECC PROGRAM AS FOLLOWS ON OCCUPIED MODE, SYSTEM OPERATES AS INDICATED ABOVE.
  2. OCCUPIED CONTROL IS 0600 TO 1800 EXCEPT WEEKENDS.
  3. ON UNOCCUPIED CONTROL, TERMINAL SUPPLY BOXES FOR THE OPERATING ROOMS SHALL BE RETURNED TO INDICATED AIR QUANTITIES. AIR FLOWS FOR THE OPERATING ROOMS ARE AS FOLLOWS:

	OCCUPIED SUPPLY	UNOCCUPIED SUPPLY	OCCUPIED EXH	UNOCCUPIED EXH
GEN. O.R.	50100	1250	500	1050
GEN. O.R.	50101	1430	575	1175
GEN. O.R.	50103	1430	575	1175
GEN. O.R.	50104	1430	575	1175
ORTHO. O.R.	50105	1480	600	1225
AMB. O.R.	50109	1140	460	1050
AMB. O.R.	50110	1140	460	1050
CTSD.	50121	1230	500	1000
CTSD.	50123	1230	500	1000

4. DURING THE UNOCCUPIED PERIOD, SUPPLY AND EXHAUST TO ALL OF THE REMAINING AREAS SERVED BY 1-AC32 SHALL BE SAME AS DURING OCCUPIED CYCLE.
5. IN ADDITION, DURING THE OCCUPIED CYCLE ANY INDIVIDUAL OPERATING ROOM MAY BE RETURNED TO UNOCCUPIED AT THE ADJUSTMENT PANEL LOCATED IN THE OPERATING ROOM, AT THE MASTER ADJUSTMENT PANEL, IN THE NURSING STATION, OR AT THE ECC.

Revisions

05 BUILD

6-17-94

RECORD DRAWING

CORRECTED ON BASIS OF DATA

FURNISHED BY THE RESIDENT ENGINEER

Key Plan

RTKL/CS&D/HENRY ADAMS (L.V.)

ARCHITECTS AND ENGINEERS

400 E. PRATT STREET

BALTIMORE, MD 21202

Project Title

CONTROL DIAGRAMS

HVAC

Project No.

324-BED REPLACEMENT HOSPITAL-PHASE II

Building Number

1

Location

VAMC-BALTIMORE, MD

Date

9/1/88

Project No.

511-001D

Drawing No.


1-H90

Drawn by

11/123

8-0-1-1350

Veterans Administration

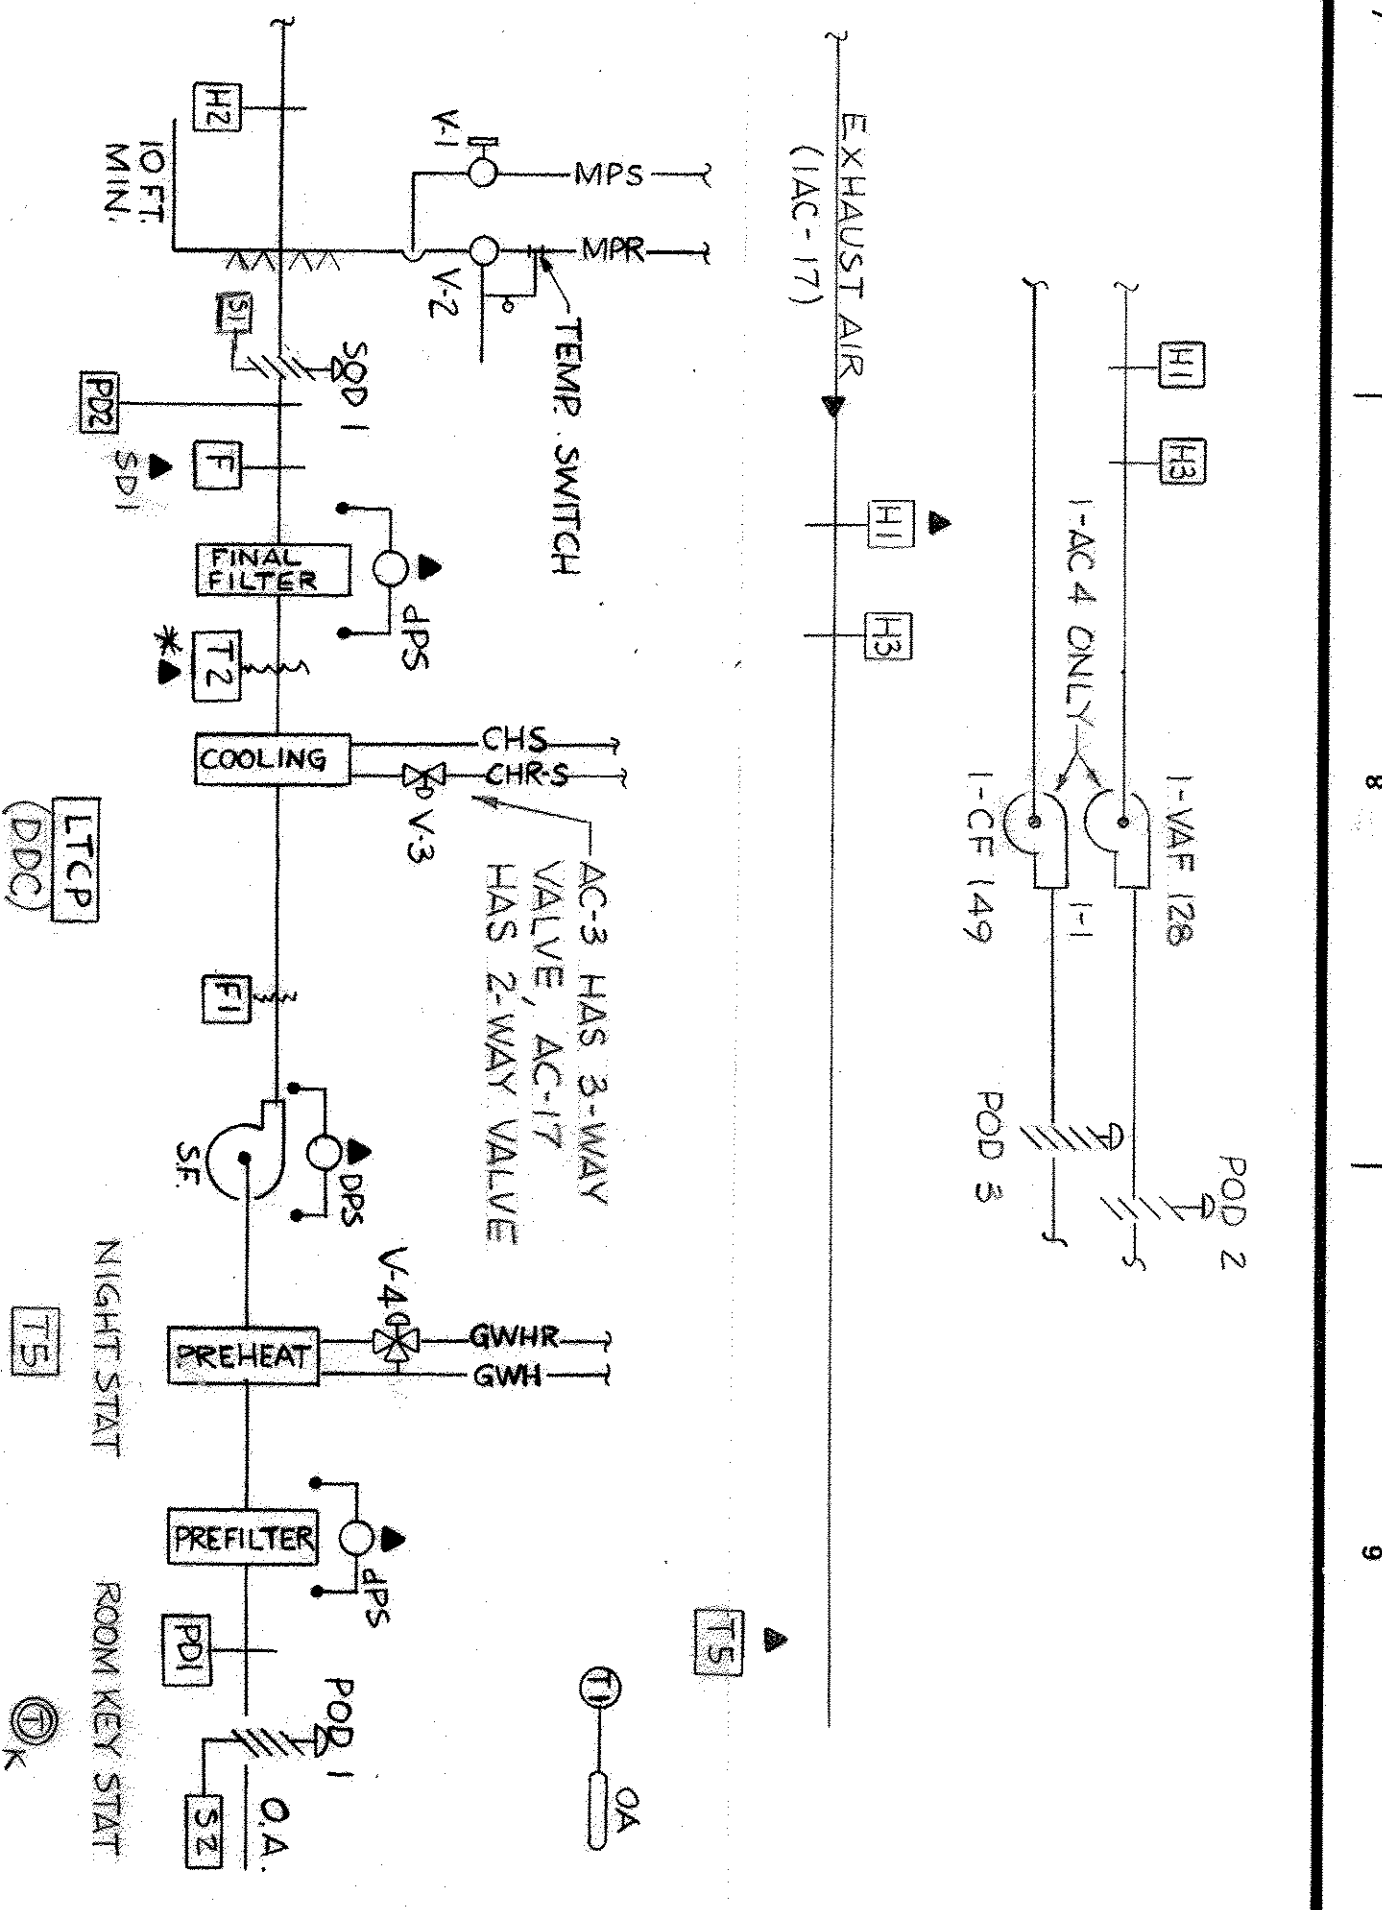

MEDIUM PRESSURE, CONSTANT VOLUME 100% O.A. SYSTEM  
1-AC-4 & 1-AC-17

- OPERATING SEQUENCE**
1. SYSTEM OPERATION IS STARTED AND STOPPED FROM THE ECC. WHEN STOPPED, P001 AND S001 CLOSE. WHEN END SWITCHES S1 AND S2 ARE ENGAGED, SF AND FAN 1-VAF146 START, AND P002 OPENS. WHEN STOPPED, SF AND FAN 1-VAF146 STOP, P002 CLOSES. AFTER 2-MINUTE DELAY (ADJUSTABLE 0-5 MINUTES) P001 AND S001 CLOSE. COMMANDS FROM ECC ARE VIA DDC PANEL.
  2. DURING OPERATION, T-2 MODULATES V-4 IN SEQUENCE TO MAINTAIN 51°F.
  3. DURING OPERATION, T-2 MODULATES V-3 TO MAINTAIN 51°F. (SEE SUPPLY AIR TEMPERATURE RESET BELOW.)
  4. DURING OPERATION WHEN O-A AT T-1 IS ABOVE 59°F., T-1 CLOSING V-4 TO COIL.
  5. ELECTRIC FREEZE/STAT F1 STOPS SF WHENEVER TEMPERATURE IS BELOW 36°F.
- STARTING AND STOPPING**
1. WHEN SYSTEM OPERATION IS STARTED FROM ECC, PRESSURE SWITCH P01 STOPS SUPPLY FAN SHOULD O.A. PLenum PRESSURE FALL BELOW MINUS 2" W.G. PRESSURE SWITCH P02 STOPS SF SHOULD PRESSURE RISE ABOVE 4" W.G. PRESSURE SWITCH SHALL BE MANUAL RESETTABLE TYPE.
- HUMIDITY CONTROL**
1. O.A. THERMOSTAT T1 SHALL CLOSE ON-OFF TWO-WAY CONTROL VALVE V-1 WHEN OUTSIDE AIR RISES ABOVE 70°F., AND OPEN VALVE V1 WHEN OUTSIDE AIR DROPS BELOW 70°F.
  2. DUCT HUMIDITY SENSOR H1 SHALL MODULATE VALVE V2 TO MAINTAIN THE DESIRED RELATIVE HUMIDITY (30% RH) SUBJECT TO ITS MODULATING TYPE HIGH LIMIT DUCT HUMIDITY SENSOR H2 SET AT 80% RELATIVE HUMIDITY. VALVE V2 SHALL CLOSE UNTIL CONDENSATE APPROACHES STEAM TEMPERATURE.
- SMOKE CONTROL**
1. WHEN SMOKE IS SENSED AT S01, SF STOPS, P001 AND S001 CLOSE. FANS VAF128 AND CF149 RUN.
- OCCUPIED-UNOCCUPIED MODES**
1. SYSTEM MODE IS CONTROLLED BY ECC PROGRAM AS FOLLOWS. ON OCCUPIED MODE, SYSTEM OPERATES AS INDICATED ABOVE. ON UNOCCUPIED MODE, SYSTEM IS STOPPED AND WHEN O.A. AT T1 IS BELOW 50°F., NIGHT STAT T-5 Cycles SYSTEM TO MAINTAIN 70°F.
  2. OCCUPIED MODE TO BE DETERMINED.
  3. THREE-POSITION SWITCH S1 (OCCUPIED-UNOCCUPIED-AUTOMATIC) AT LTCP PERMITS MANUAL TIMER OVERRIDE.
- SUPPLY AIR TEMPERATURE (OCCUPIED CYCLE)**
1. KEY REQUEST ON EXHAUST AIR HUMIDISTAT H-3, SET AT 60% RH WITH GREATEST COOLING DEMAND, RESETS T-2 TO MINIMUM TEMPERATURE.
  2. KEY ZONES ARE INDICATED ON DRAWINGS.